

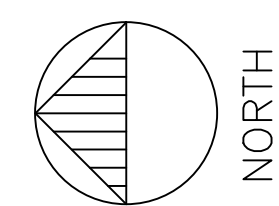


North Building
Lower Level

South Building
1st floor

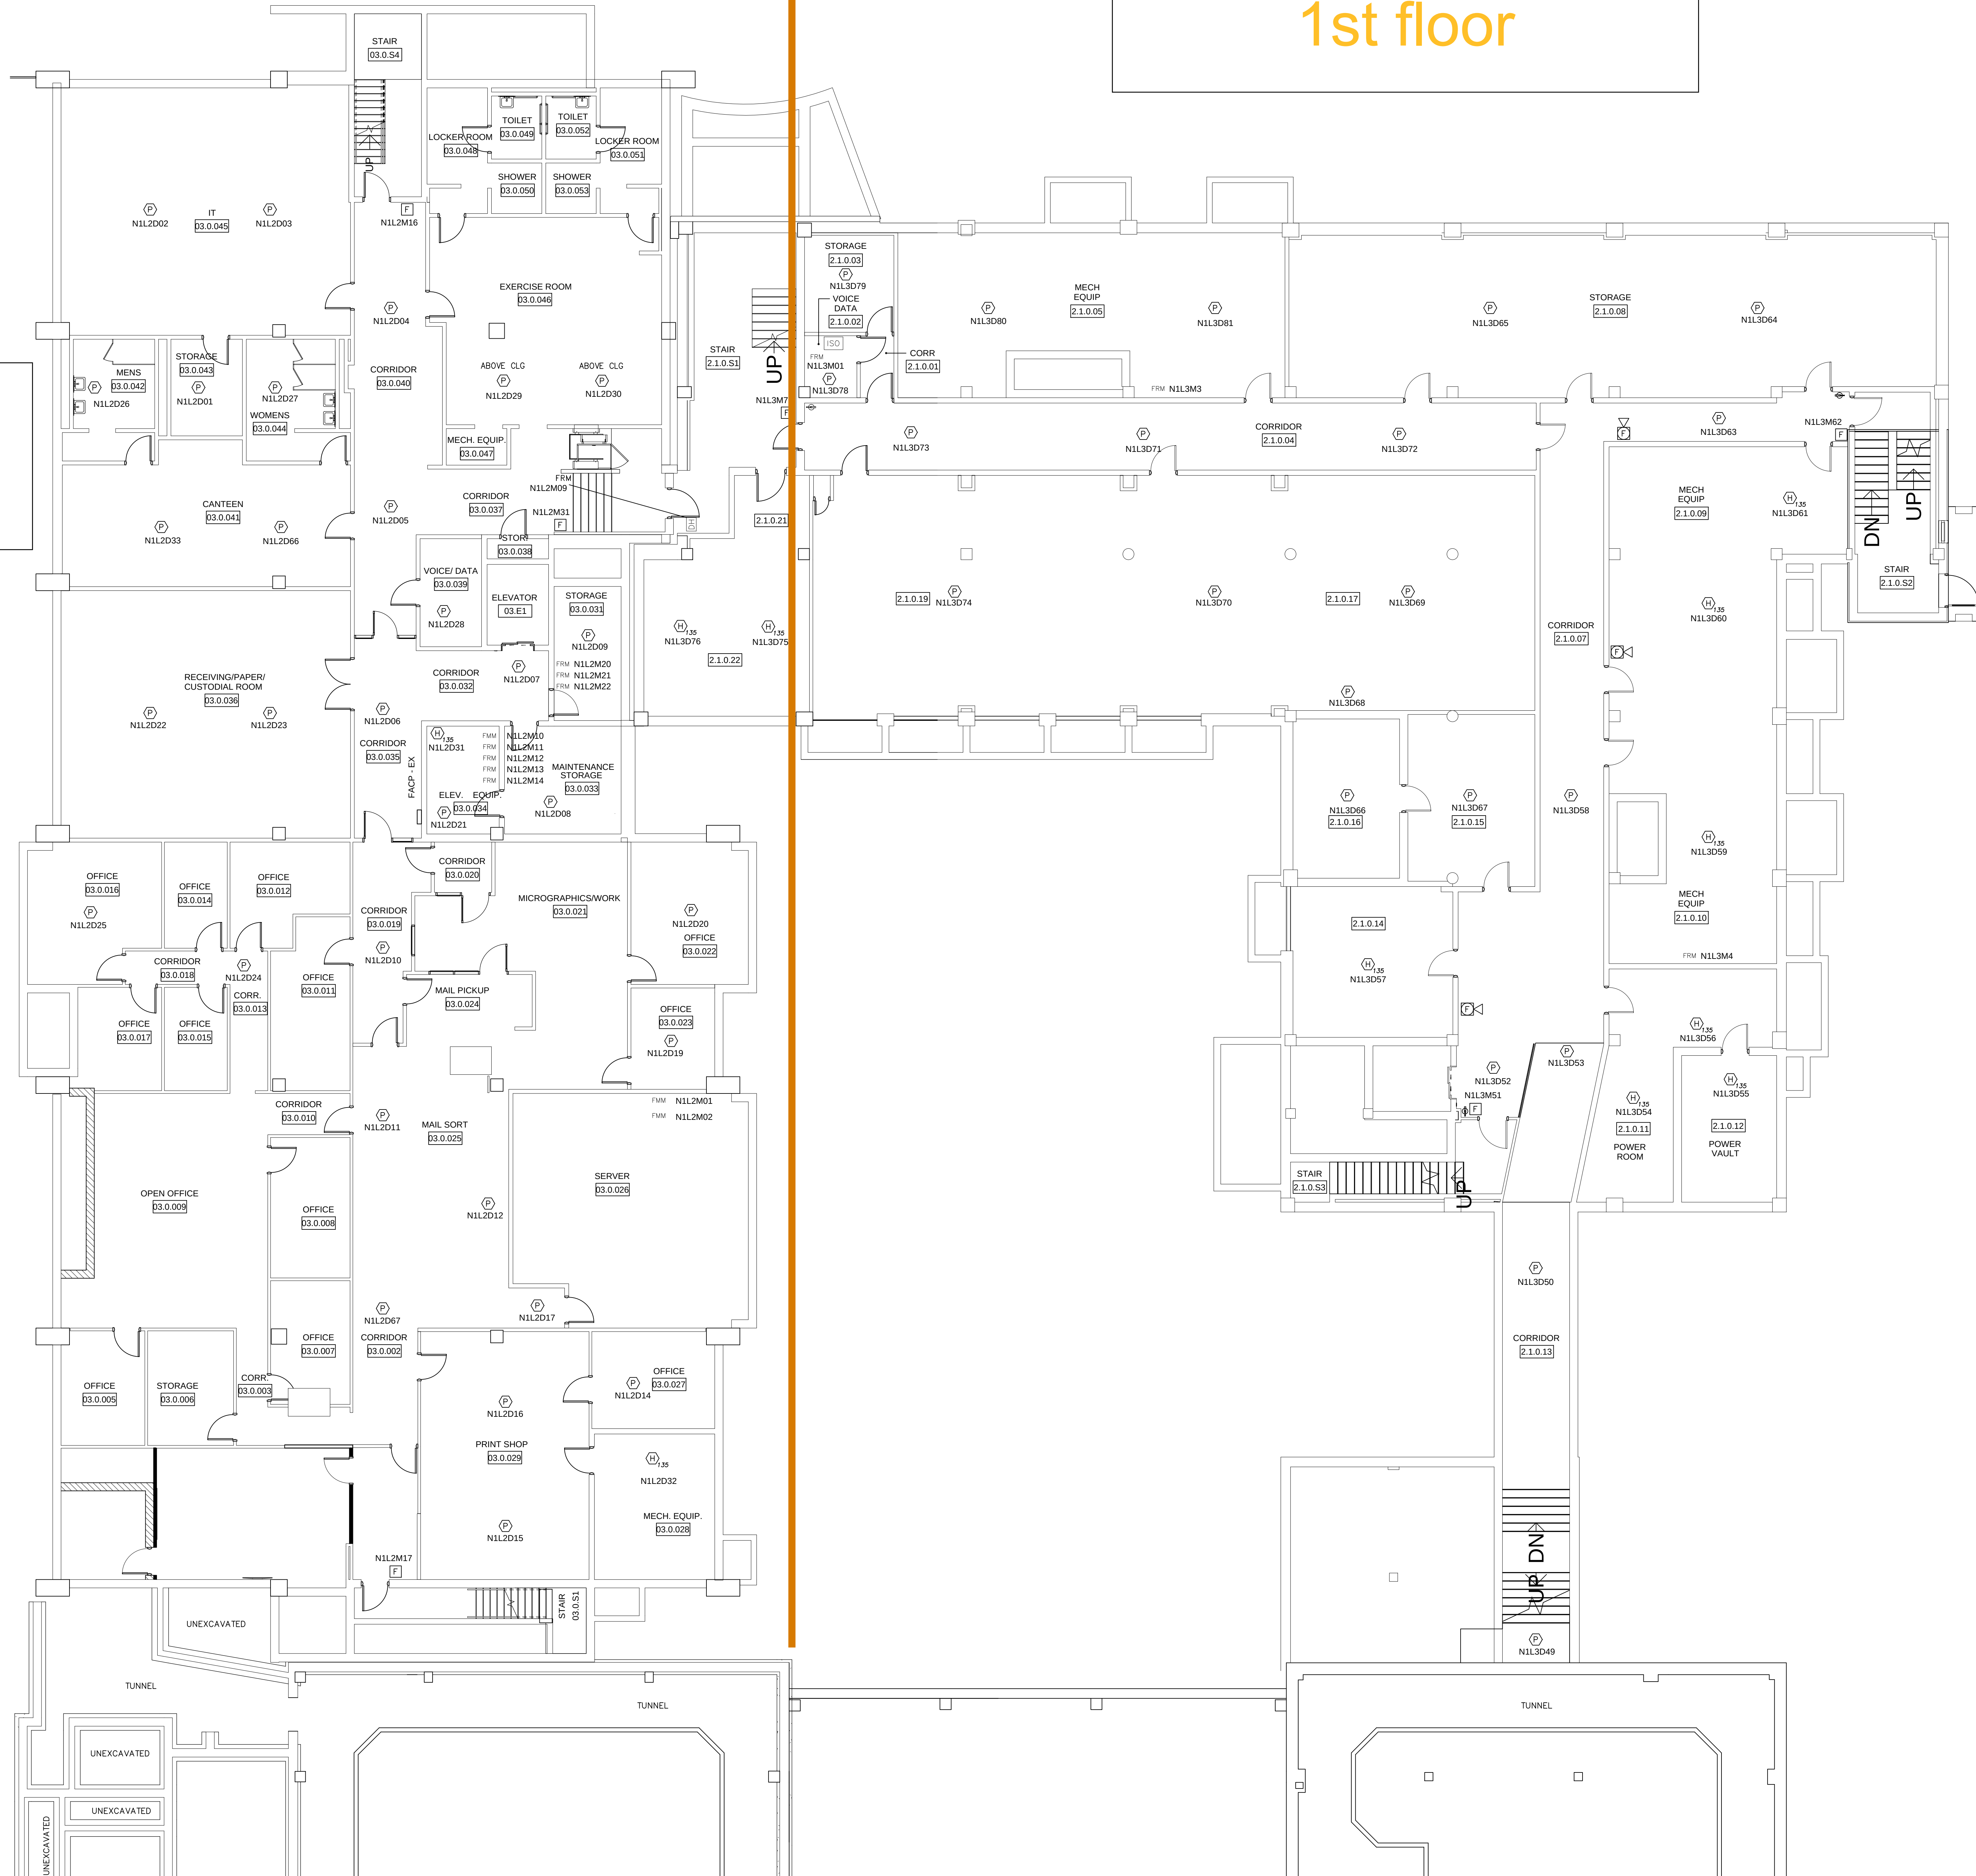

1 LOVER LEVEL - AREA B
SCALE: 1/8"=1'-0"

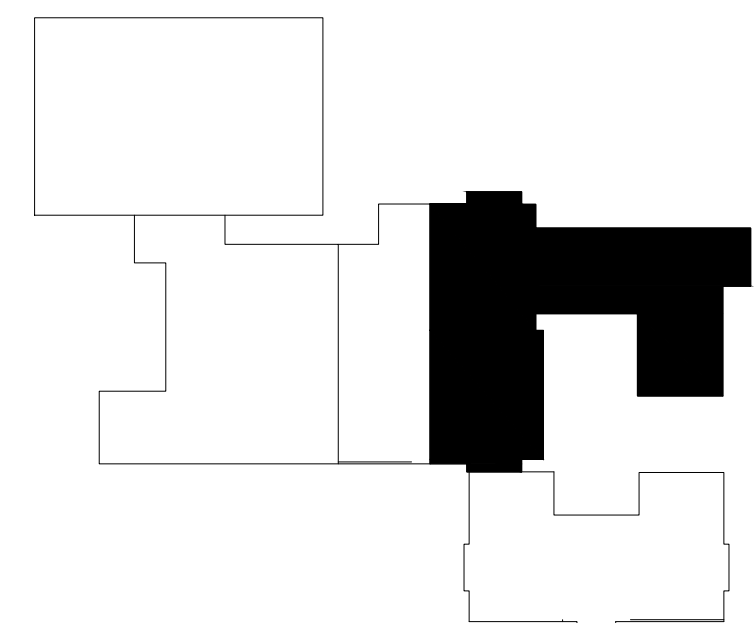

W593 VETERANS AVENUE
SHERWOOD, WI 54169
PHONE 800-282-0526
FAX 920-439-1366
WWW.LEGACY-COMMUNICATIONS.COM
INFO@LEGACY-COMMUNICATIONS.COM

This drawing, data, and designs
thereon shall not be duplicated, used
or disclosed to others for
procurement or other purpose except
as otherwise authorized by contract,
without written permission of Legacy
Communications LLC. All reproductions
shall bear this notice.

REVISION NUMBER	REVISION DATE	REVISION BY
0	10-3-17	DJN
1	05-6-19	DJN
2	05-22-19	JLJ
3	06-29-20	DJN
4	08-07-20	DJN

REVISION DESCRIPTION
ORIGINAL
AS-BUILT
AS-BUILT
AS-BUILT REVISIONS
AS-BUILT

CUSTOMER
OUTAGAMIE COUNTY ADMINISTRATION CENTER ADDITION / ALTERATION

TITLE
OCAC NORTH/SOUTH BUILDING LOWER LEVEL - AREA B

APPROVAL

DRAWN BY	DATE
DJN	07-31-17


CHECKED BY	SCALE
PT	1:1

DRAWING NUMBER
8030-006

Government Center 1st floor

North Building 1st Floor

South Building 2nd Floor

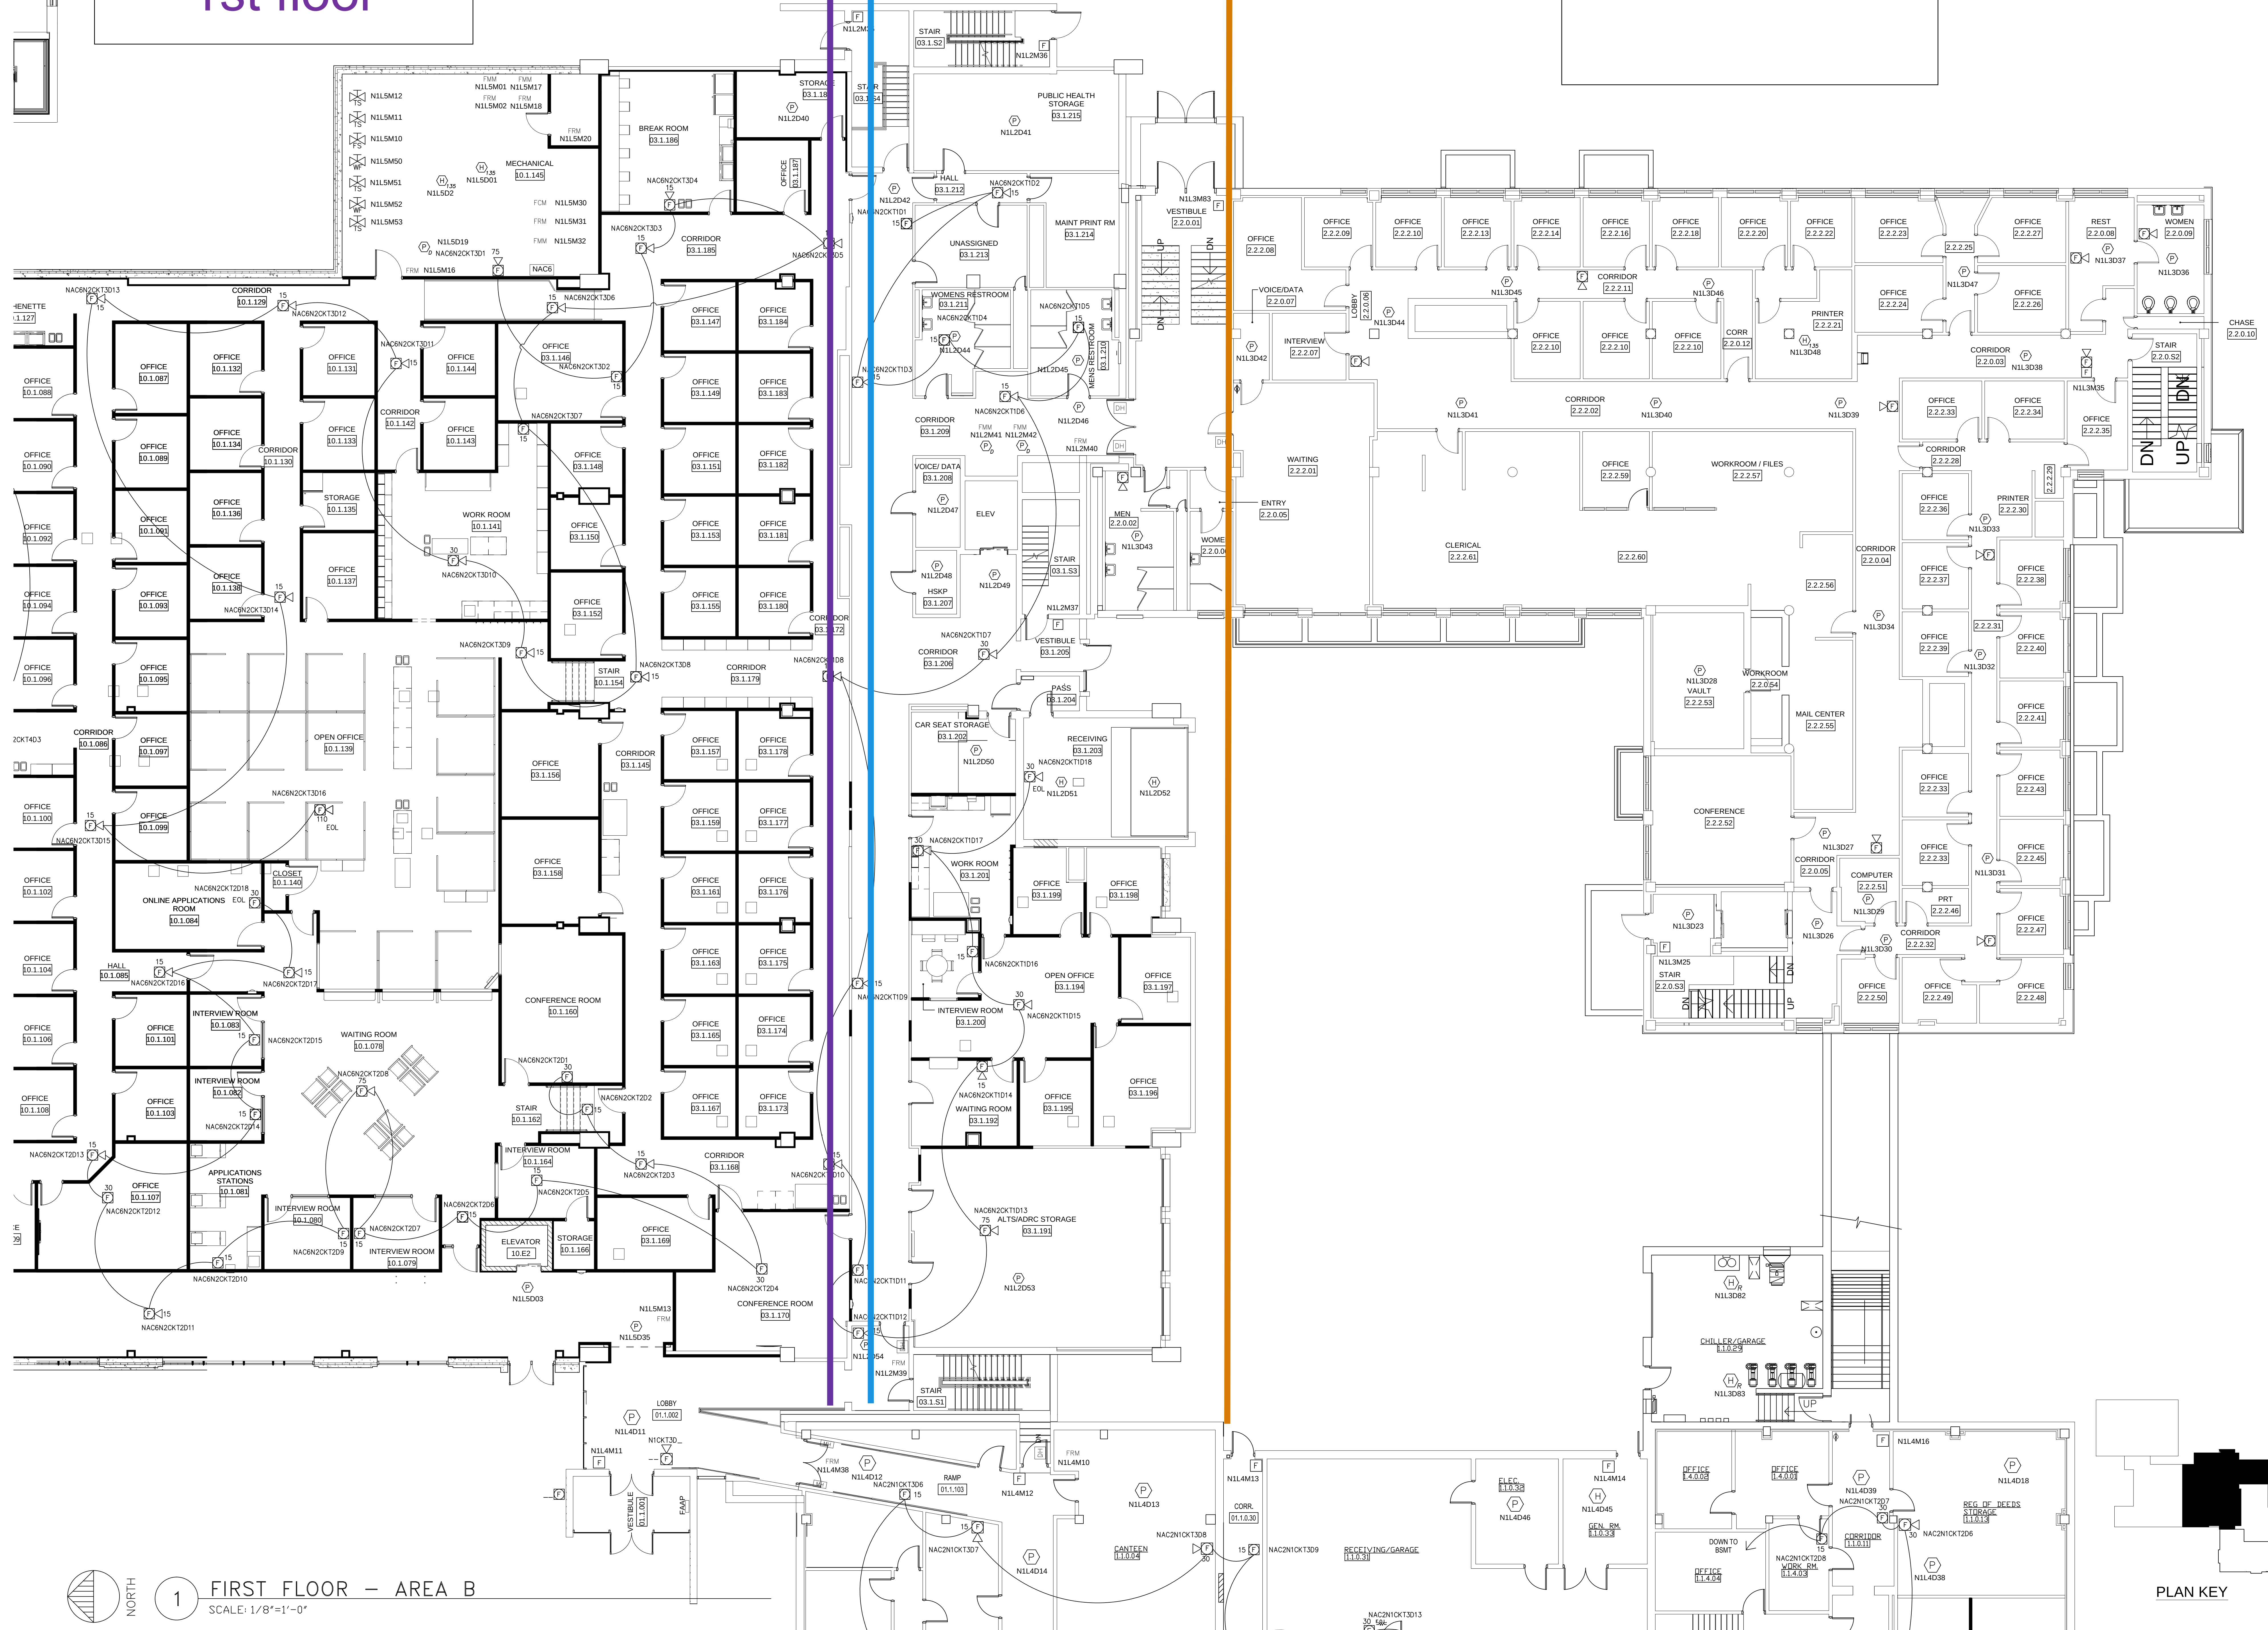

PLAN KEY



W593 VETERANS AVENUE
SHERWOOD, WI 54169
PHONE 800-282-0526
FAX 920-439-1366
WWW.LEGACY-COMMUNICATIONS.COM
INFO@LEGACY-COMMUNICATIONS.COM

This drawing, data, and designs thereon shall not be duplicated, used or disclosed to others for procurement or other purpose except as otherwise authorized by contract, without written permission of Legacy Communications LLC. All reproductions shall bear this notice.

REVISION NUMBER	REVISION DESCRIPTION	REVISION DATE	REVISION BY
1	AS-BUILT	3-28-18	D.J.N.
2	AS-BUILT	05-6-19	D.J.N.
3	AS-BUILT	05-22-19	J.L.J.
4	AS-BUILT REVISIONS	06-29-20	D.J.N.
5	AS-BUILT	08-07-20	D.J.N.

CUSTOMER
OUTAGAMIE COUNTY
ADMINISTRATION
CENTER
ADDITION /
ALTERATION

TITLE
OCAC
NORTH SOUTH
BUILDING FIRST
FLOOR PLAN -
AREA B

APPROVAL
DRAWN BY
DATE
CHECKED BY
SCALE
DRAWING NUMBER

8030-009


PLAN KEY

Government Center 2nd floor


At this point the North building now becomes the Gov't Center

North Building 2nd Floor

South Building 3rd Floor

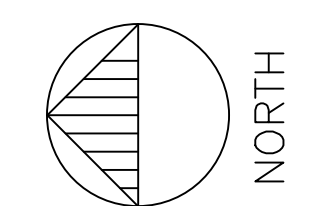

1 NORTH_SOUTH BUILDING SECOND FLOOR - AREA B
SCALE: 1/8"=1'-0"

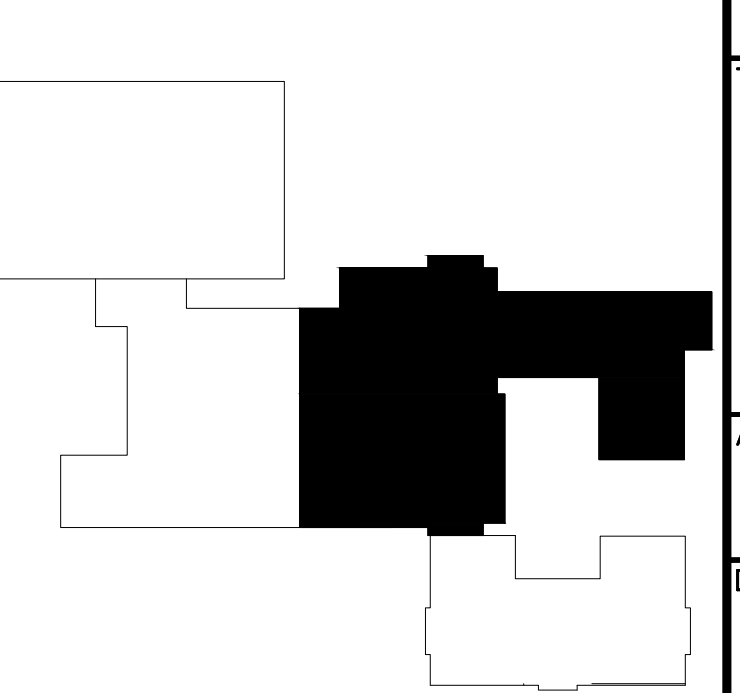

5939 VETERANS AVENUE
SHERWOOD, WI 54169
PHONE 800-282-0526
FAX 920-439-1366
WWW.LEGACY-COMMUNICATIONS.COM
INFO@LEGACY-COMMUNICATIONS.COM

This drawing, data, and designs thereon shall not be duplicated, used or disclosed to others for procurement or other purpose except as otherwise authorized by contract, without written permission of Legacy Communications LLC. All reproductions shall bear this notice.

REVISION NUMBER	REVISION DESCRIPTION	REVISION DATE	REVISION BY
0	ORIGINAL	10-3-17	DJN
1	AS-BUILT	3-28-18	DJN
2	AS-BUILT	05-22-19	DLJ
3	AS-BUILT REVISIONS	06-29-20	DJN
4	AS-BUILT	08-07-20	DJN

CUSTOMER	OUTAGAMIE COUNTY ADMINISTRATION CENTER ADDITION / ALTERATION
TITLE	OCAC NORTH_SOUTH BUILDING SECOND FLOOR PLAN - AREA B
APPROVAL	
DRAWN BY	DJN
CHECKED BY	PT
DATE	07-31-17
SCALE	1:1
DRAWING NUMBER	8030-013