PENTHOUSE ROOF

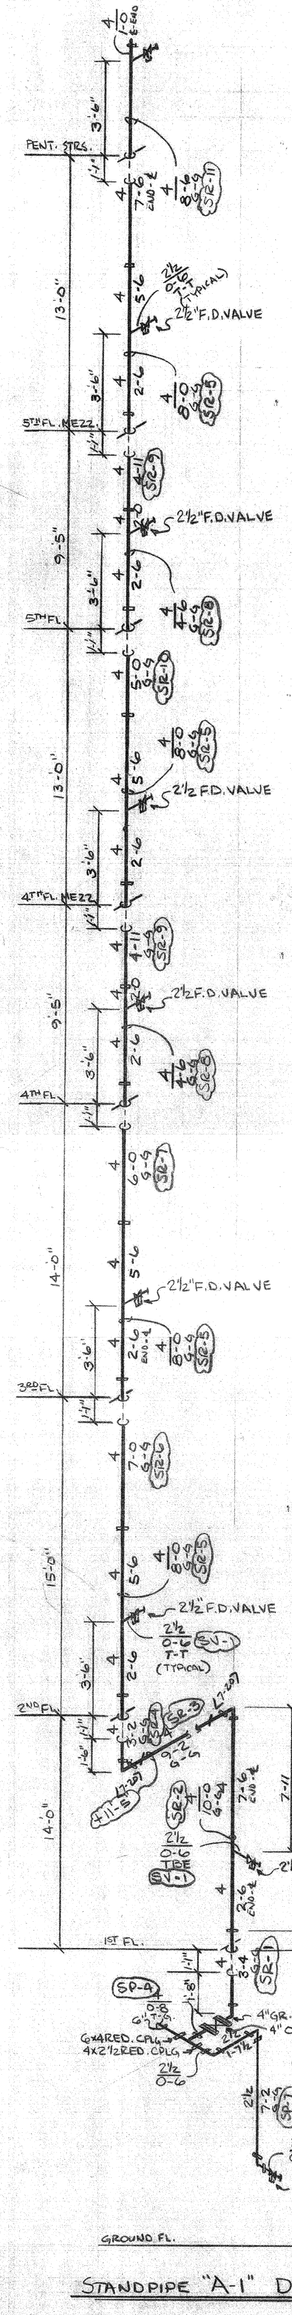

STANDPIPE "A-1" DETAIL

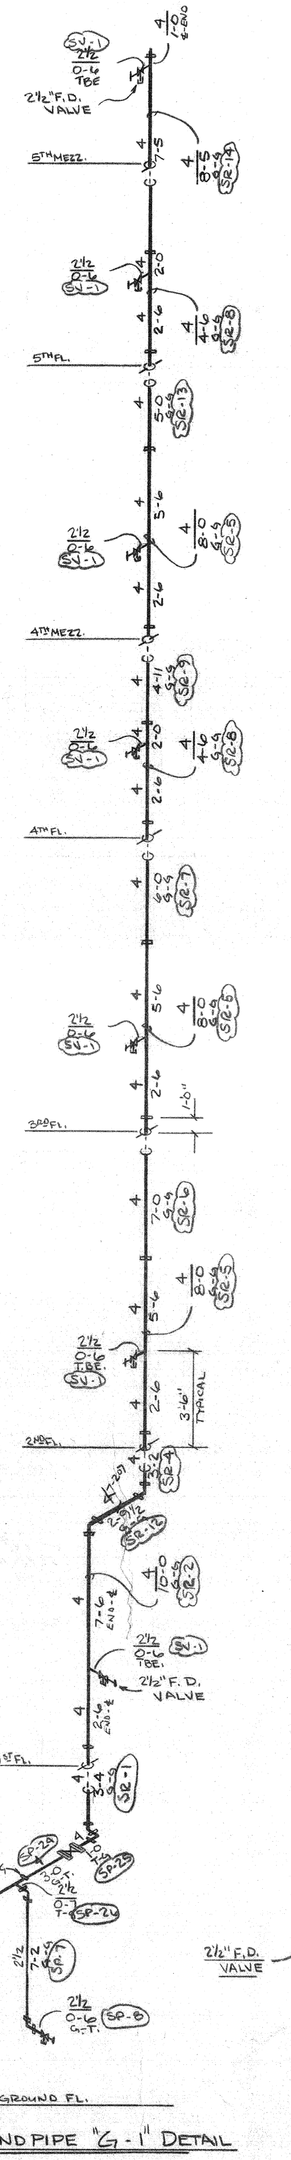

STANDPIPE "G-1" DETAIL

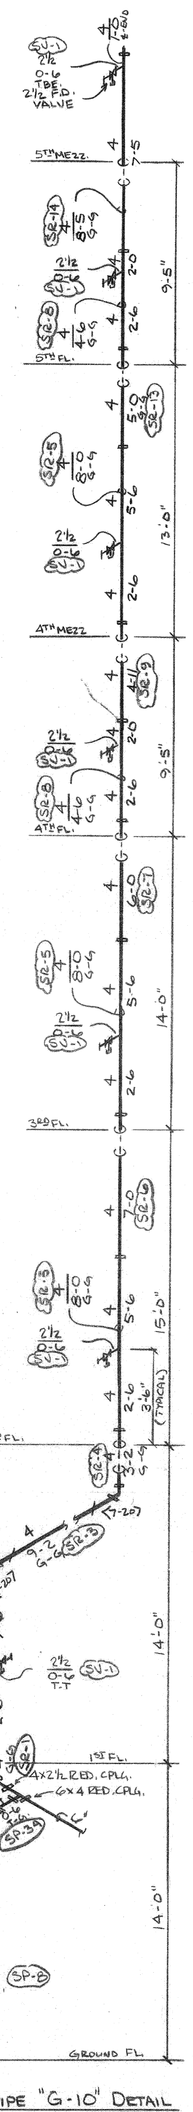

STANDPIPE "G-10" DETAIL

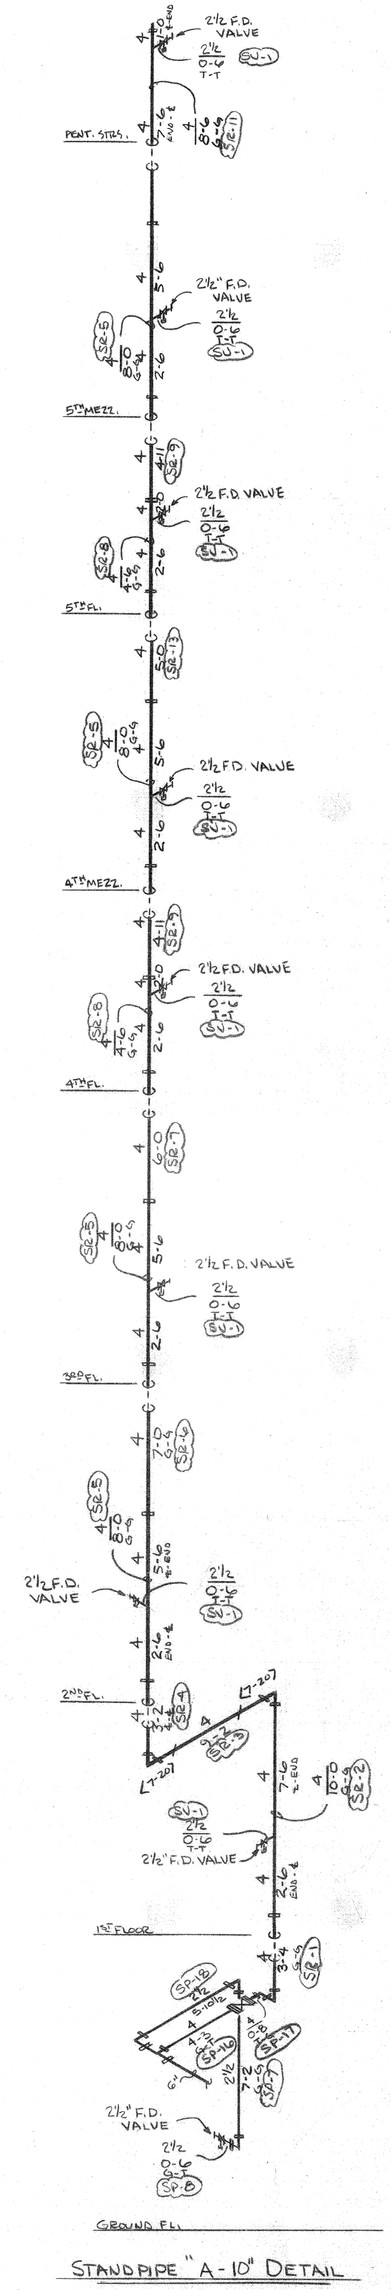

STANDPIPE "A-10" DETAIL

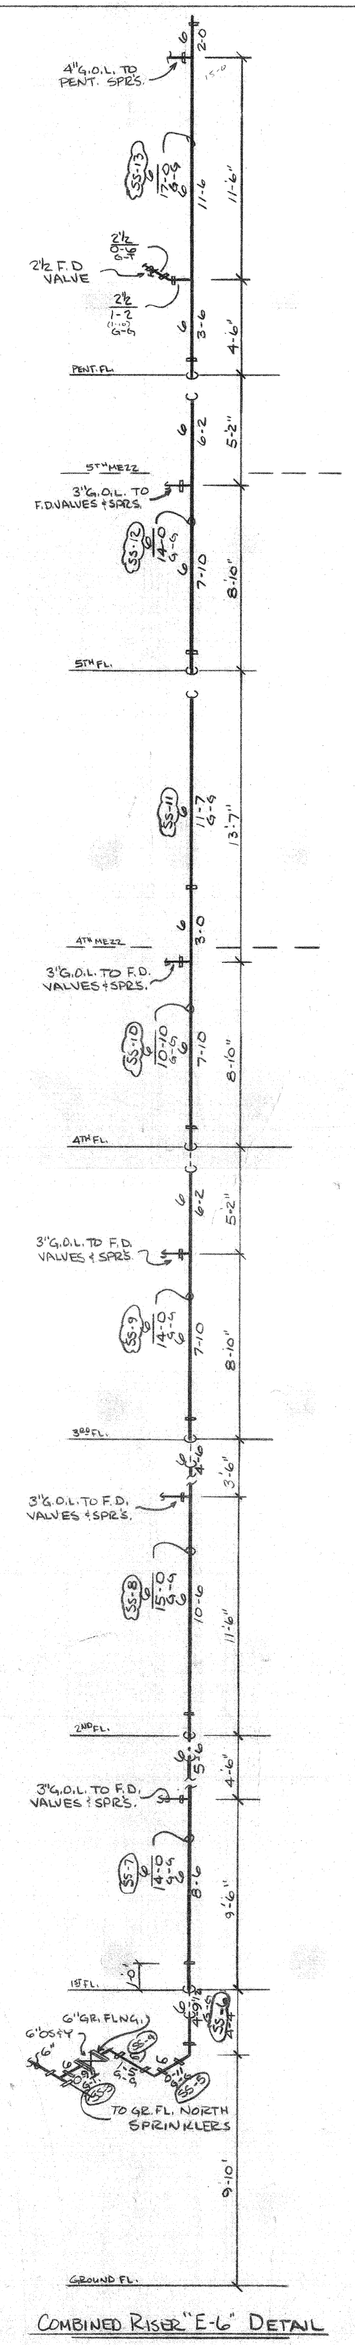

COMBINED RISER "E-6" DETAIL

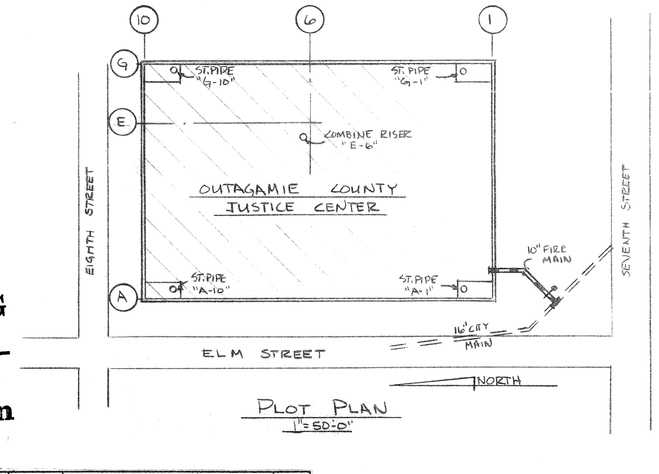

PLOT PLAN
1" = 50'-0"

RECORD DRAWING
Date 11/20/92
United States Fire Protection

REV	DATE	DESCRIPTION	BY
1	10-24-90	COMP. FOR FAB	

SPRINKLER TYPE	165	212	286	FINISH	TOTAL
				THIS SHEET	
				TOTAL ON JOB	

SHEET TITLE: STAND PIPE DETAILS, PLOT PLAN
PROJECT: OUTAGAMIE CO. JUSTICE CENTER
APPLETON, WISC.

UNITED STATES FIRE PROTECTION
17750 W. LIBERTY LA. NEW BERLIN, WI. 53146
(414) 782-3311

REVIEW AGENCY: I.S.O.N.J.
DATE: 9-15-90
SCALE: 1/8"=1'-0"
JOB NO.: 1544
DRAWN BY: E.D.
SHEET: FP-1A