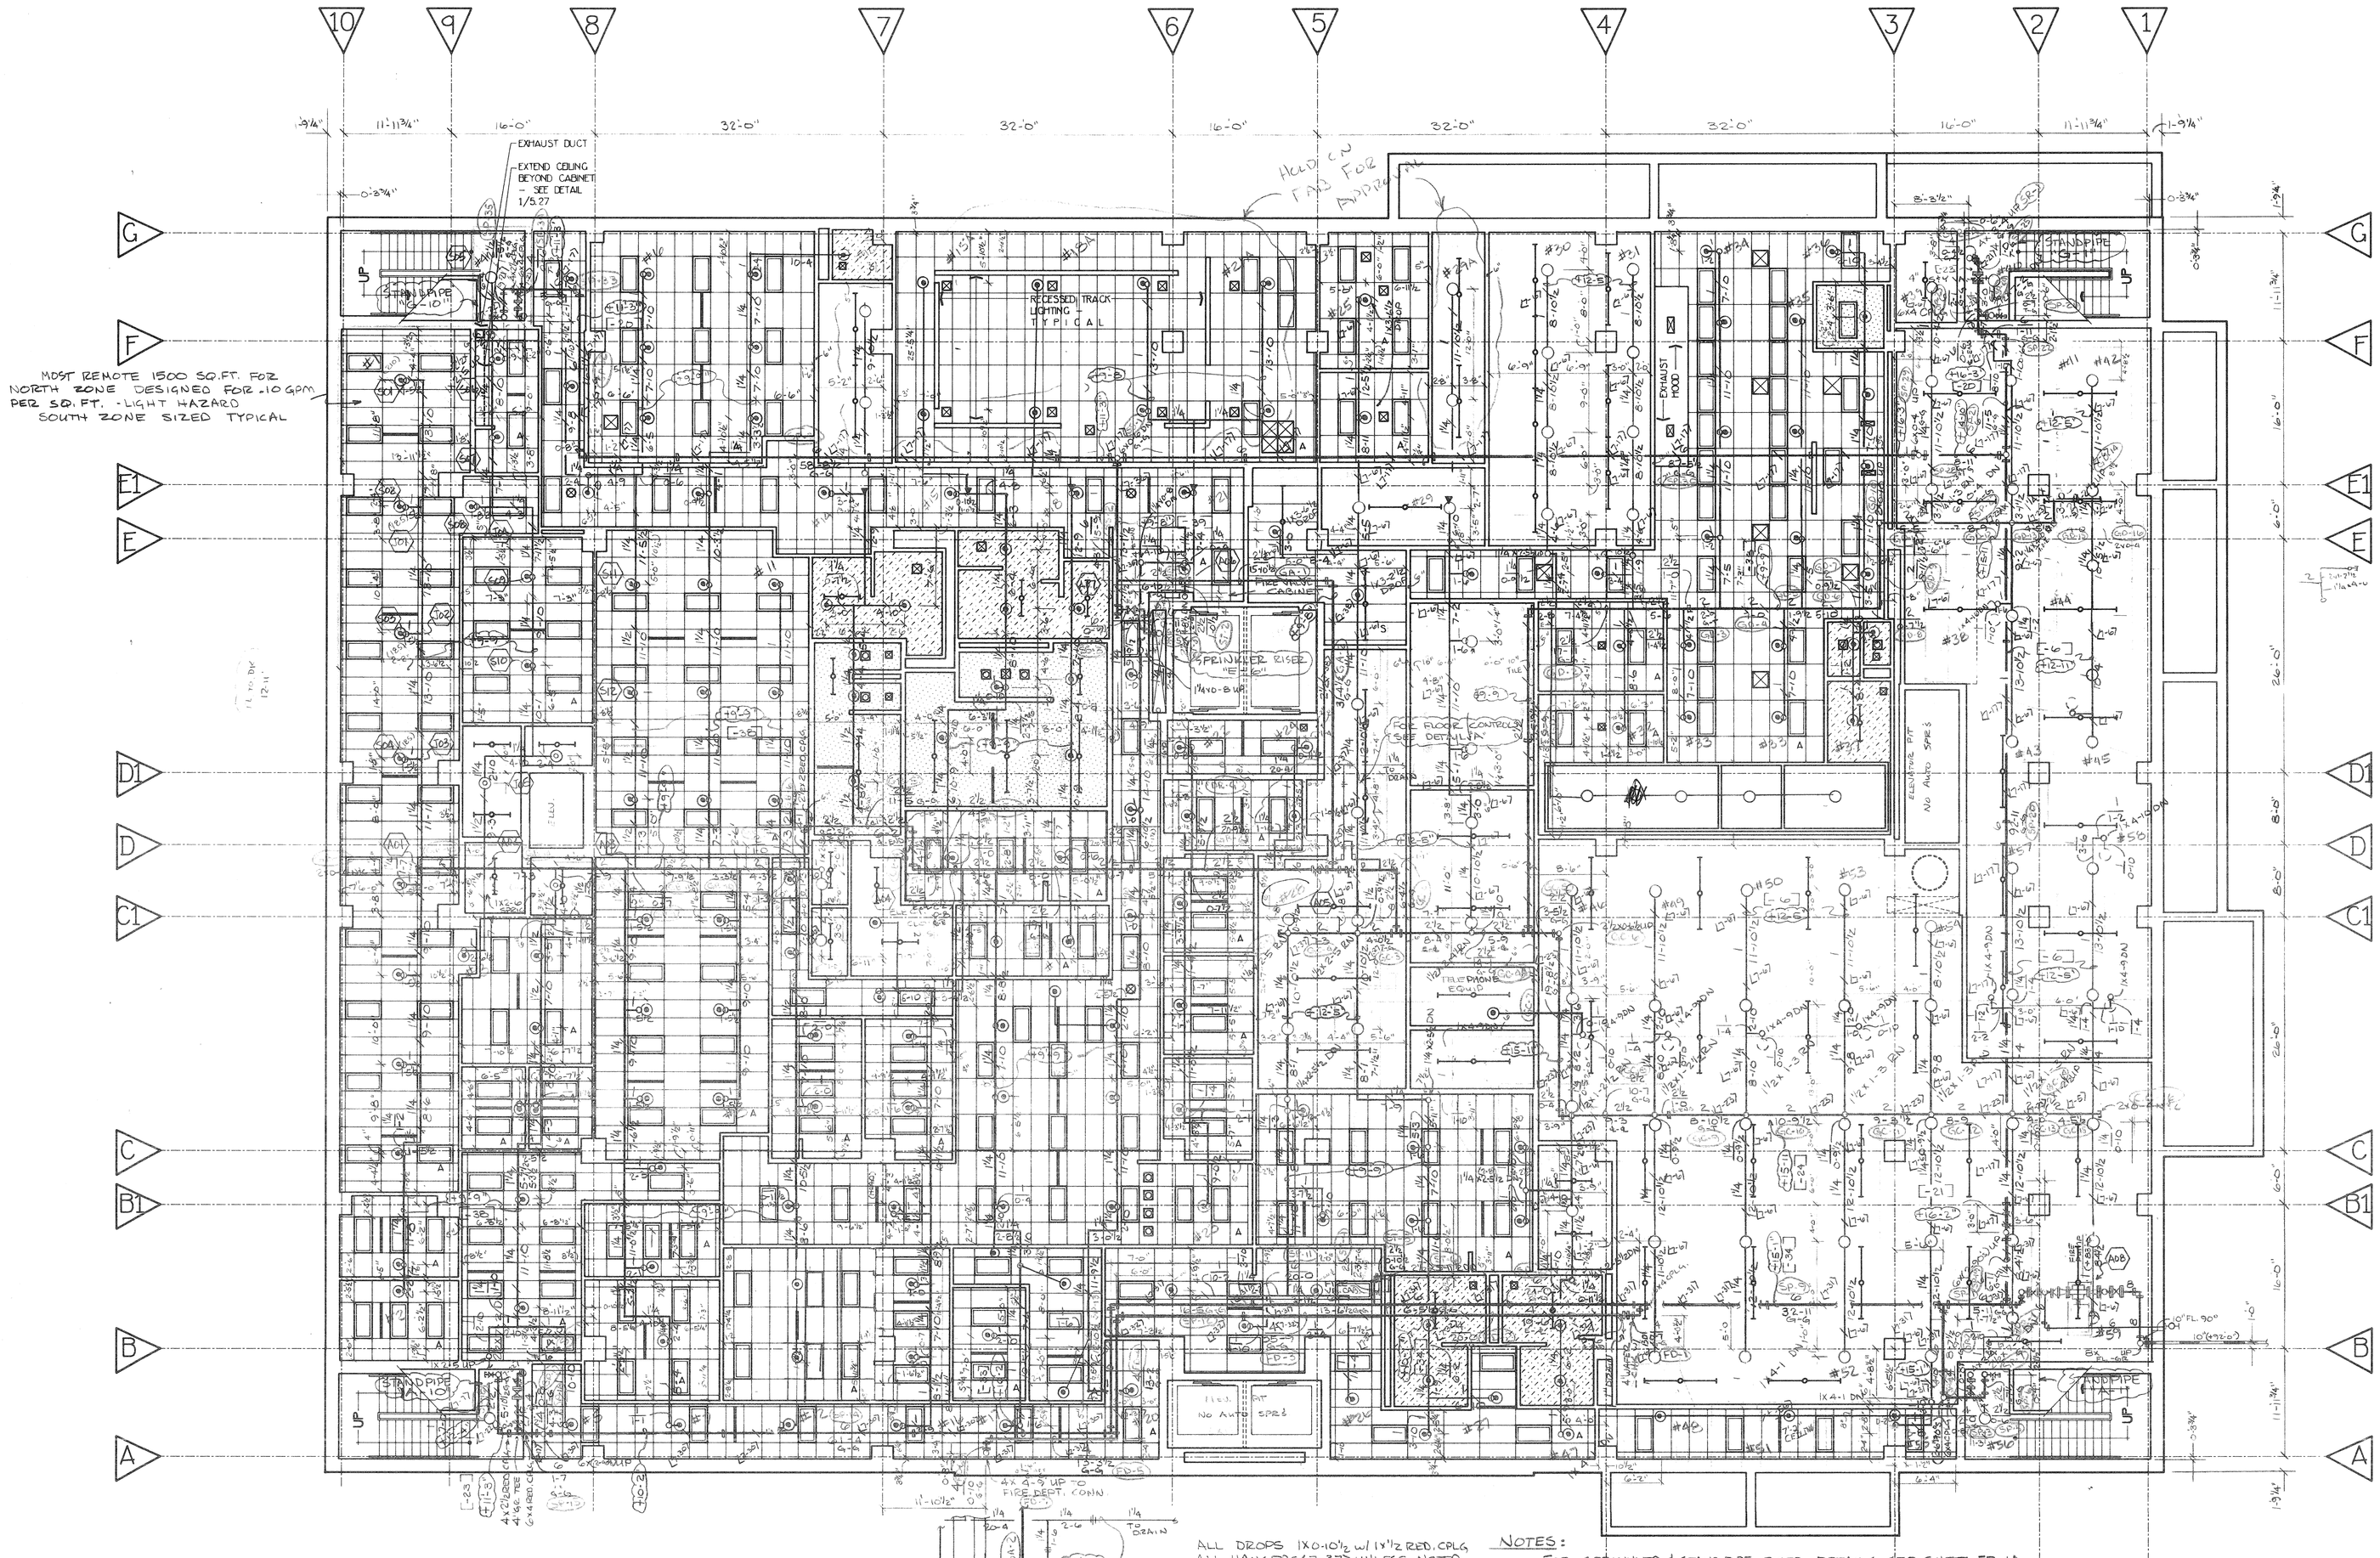

RECORD DRAWING
Date 11/20/92
United States Fire Protection

SPRINKLER TYPE	165	212	286	FINISH	TOTAL
½" PENDANT	169			CHROME	169
½" UPRIGHT	82			BRASS	82
				THIS SHEET	251
				TOTAL ON JOB	

UNITED STATES FIRE PROTECTION
17750 W. LIBERTY LA. NEW BERLIN, WI. 53146
(414) 782-3311

Potter Lawson ARCHITECTS
15 Ellis Potter Court
Madison, Wisconsin
608 274-2741

Moyer Associates Incorporated
378 Park Avenue, P.O. Box 250
Glencoe, Illinois 60022 312/835-1234

ARCHITECTS AND ASSOCIATES
129 EAST COLLEGE AVENUE
SUITE 200
APPLETON, WISCONSIN 54911
414-730-0055

ARNOLD & O'SHERIDAN, INC.
CONSULTING ENGINEERS
815 FORWARD DRIVE MADISON, WISCONSIN 53711
608-271-9551 JOB NO.

Seal & Notes

REFLECTED CEILING PLAN KEY

- RECESSED FLOURESCENT FIXTURE
- RECESSED FLOURESCENT FIXTURE
- RECESSED FLOURESCENT FIXTURE
- RECESSED 'CAN' FIXTURE
- SURFACE MOUNTED 'EXIT' FIXTURE
- SURFACE MOUNTED OR SUSPENDED FLOURESCENT FIXTURE
- SURFACE MOUNTED OR SUSPENDED FLOURESCENT FIXTURE
- LINEAR DEFUSER
- HVAC GRILLE (SIZE VARIES)
- AP NON-SECURITY ACCESS PANEL (SIZE VARIES)
- SAP SECURITY ACCESS PANEL (SIZE VARIES)
- A 2'X2' SUSPENDED CEILING
- A 2'x4' SUSPENDED CEILING
- S SECURITY CEILING
- PLASTER CEILING
- GVB CEILING

R.C.P. NOTES:

VERIFY ALL REFLECTED CEILING PLANS WITH ARCHITECTURAL, STRUCTURAL, PLUMBING, HVAC OR ELECTRICAL DRAWINGS

ALL ACCESS PANELS ARE 24" x 24" UNLESS NOTED ON THE PLANS

Date	Issuance / Revisions	Symbol
10-31-90	SPRINKLERS COMP. FOR FAB	
10-26-90	STANDPIPES COMP. FOR FAB	
10-8-90	SPRINKLER PLAN - FOR APPROVAL	
9-13-90	ISSUED AS STANDPIPE PLAN	

APPLETON, WISCONSIN

OUTAGAMIE COUNTY JUSTICE CENTER

Drawing Title
GROUND FLOOR
STANDPIPE AND SPRINKLER PLAN

Project No.	SCHEME AGENCY	DATE
1544	I.S.O. W.	9-13-90
Drawn By: DLSON	DRAWING NO. FP-1	

MASTER BLUE PRINT INC. 232896