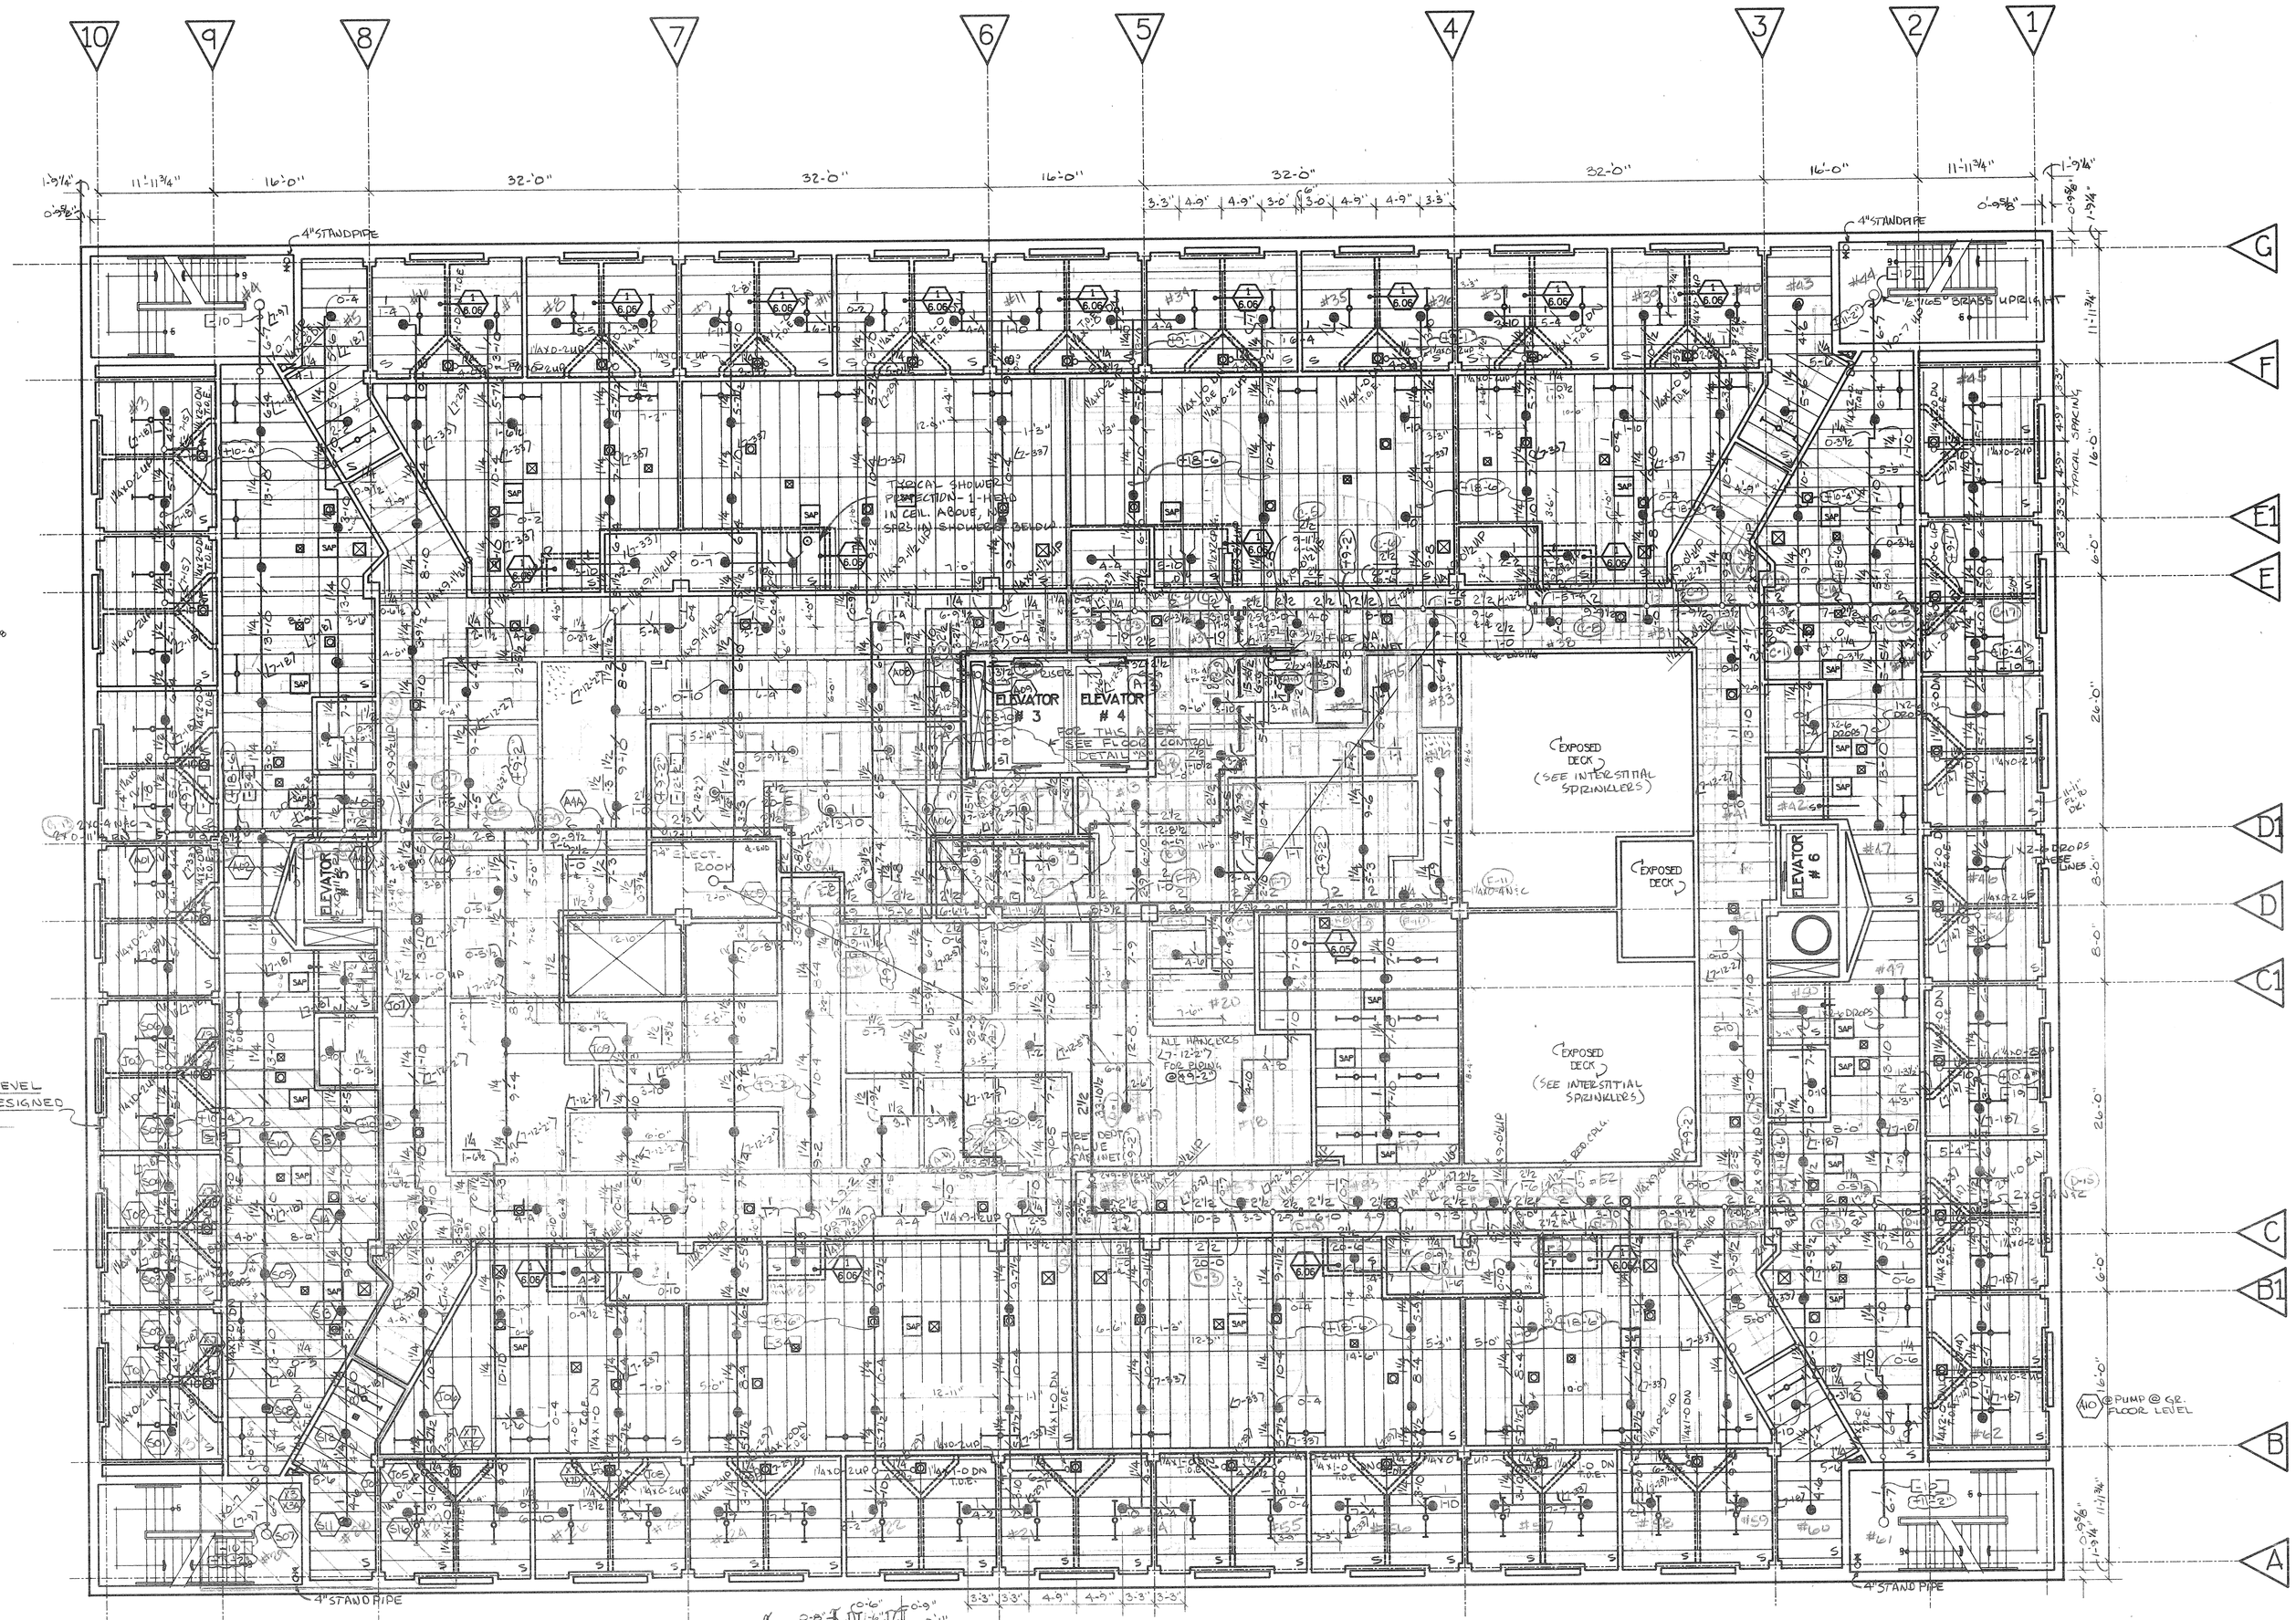

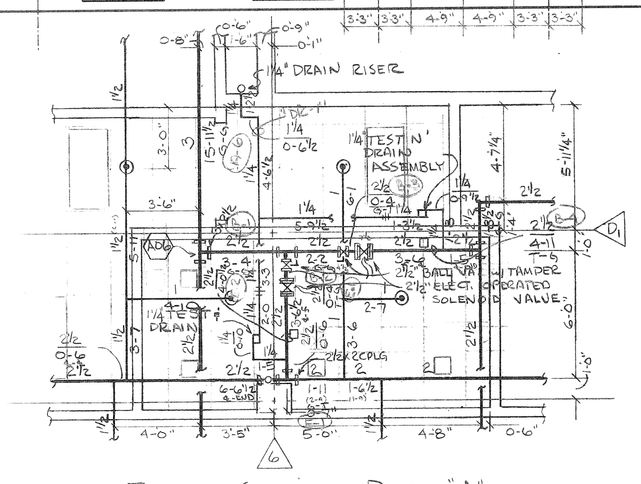

FLOOR CONTROL DETAIL "A"
SCALE: 1/4" = 1'-0"

ALL HANGERS (7-33) (1-31"4) UNLESS NOTED

ALL DROPS 1X1'-0" UNLESS NOTED W 1X1/2 RED. CPLG.

NORTH

UPPER LEVEL
FOURTH FLR. MEZZ.
SCALE: 1/8" = 1'-0"

RECORD DRAWING
Date 11/20/92
United States Fire Protection

SPRINKLER TYPE	165	212	286	FINISH	TOTAL
1/2" INSTITUTIONAL PENDENT	259			CHROME	259
1/2" STD. CHR. PEND.	10			CHROME	10
1/2" UPRIGHT	8			BRASS	13
				THIS SHEET	282
				TOTAL ON JOB	

UNITED STATES FIRE PROTECTION
17750 W. LIBERTY LA. NEW BERLIN, WI. 53146
(414) 782-3311

Potter Lawson ARCHITECTS
15 Ellis Potter Court
Madison, Wisconsin
608 274-2741

Moyer Associates Incorporated
378 Park Avenue, P.O. Box 250
Glencoe, Illinois 60022 312/835-1234

ARCHITECTS AND ASSOCIATES
129 EAST COLLEGE AVENUE
SUITE 200
APPLETON, WISCONSIN 54911
414-730-0055

ARNOLD & O'SHERIDAN, INC.
CONSULTING ENGINEERS
210 FORWARD DRIVE MADISON, WISCONSIN 53711
608-271-9681
JOB NO. _____

Seal & Notes

REFLECTED CEILING PLAN KEY

- RECESSED FLOURESCENT FIXTURE
- RECESSED FLOURESCENT FIXTURE
- RECESSED FLOURESCENT FIXTURE
- RECESSED 'CAN' FIXTURE
- SURFACE MOUNTED 'EXIT' FIXTURE
- SURFACE MOUNTED OR SUSPENDED FLOURESCENT FIXTURE
- SURFACE MOUNTED OR SUSPENDED FLOURESCENT FIXTURE
- LINEAR DEFUSER
- HVAC GRILLE (SIZE VARIES)
- NON-SECURITY ACCESS PANEL (SIZE VARIES)
- SECURITY ACCESS PANEL (SIZE VARIES)
- SPRINKLER HEAD-165° 1/2" INSTITUTIONAL PENDENT
- SPRINKLER HEAD-165° 1/2" STANDARD PENDENT
- 2'X2' SUSPENDED CEILING
- 2'x4' SUSPENDED CEILING
- SECURITY CEILING
- PLASTER CEILING
- GWB CEILING

R.C.P. NOTES:

1. VERIFY ALL REQUIRED CEILING PENETRATION QUANTITIES, LOCATIONS & SIZES W/ PLUMBING, H.V.A.C. OR ELECTRICAL DRAWINGS
2. ALL ACCESS PANELS ARE 24"x24" UNLESS NOTED ON THE PLANS

1/E.06 STOP WALLS AT UNDERSIDE OF SECURITY CEILING - SEE DETAIL 8/S.32

Date	Issuance / Revisions	Symbol
2-21-91	FINISH FOR FAB	
12-18-90	ISSUED FOR APPROVAL	
3/1/90	ISSUED FOR BIDDING - PHASE 2	

APPLETON, WISCONSIN

OUTAGAMIE COUNTY JUSTICE CENTER

Drawing Title
FOURTH FLOOR - MEZZ.
AUTOMATIC SPRINKLER PLAN

Project No.	REVIEW AGENCY:	DATE:
1544	I.S.O.W.	12-17-90
Drawn By OLSON	DRAWING NO. FP-6	